


APPLICATION FORM FOR MODIFICATION ORDER

WILDLIFE AND COUNTRYSIDE ACT 1981

To: PUBLIC RIGHTS OF WAY SECTION
OXFORDSHIRE COUNTY COUNCIL
CENTRAL LIBRARY
WESTGATE
OXFORD
OX1 1DJ

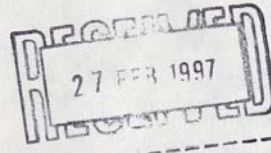

I/~~we~~ ANGELA JOAN CARTER.....(Name in Capitals)
of 12 LAWRENCE CLOSE.....(Address in Capitals)
CHILDREY
WANTAGE CANON OX12 9YR

HEREBY APPLY for an order under section 53 (2) of the Wildlife and Countryside Act 1981 modifying the Definitive Map and Statement for the area of:-

CHILDREY PARISH AND SPARSHOLT
PARISH BOTH IN THE COUNTY OF
OXFORDSHIRE

by:-

1. ~~deleting the footpath / bridleway / byway open to all traffic~~

~~from
to~~

2. ~~adding the footpath / bridleway / byway open to all traffic~~

~~from
to~~

3. ~~upgrading / downgrading to a footpath / bridleway / byway open to all traffic* the footpath / bridleway / byway open to all traffic*~~

~~from
to~~

4. ~~varying / adding to the particulars relating to the footpath / bridleway / byway open to all traffic*~~

from THE WESTERN END OF CHILDREY 17
to NORTH OF THE CANAL BRIDGE WHERE
SPARSHOLT 19 MEETS SPARSHOLT 20
by providing that

IN RED
and shown on the map annexed hereto.

The approximate width of the right of way (if known) is

The approximate length of the right of way (if known) is SEE MAP 1

I/we* attach copies of the following documentary evidence (including statements of witnesses) in support of this application:-

(Please list documents and continue on a separate sheet if necessary).

- MY GENERAL COMMENTS AND OBSERVATIONS (2 PAGES)
- MAP 1: COPY OF DEFINITIVE MAP
- MAP 2: COPY OF RELEVANT AREA FROM ORDNANCE SURVEY 1ST EDITION SURVEYED IN 1877
- MAP 3: COPY OF RELEVANT AREA FROM ORDNANCE SURVEY 25" BERKS SH 13:12 2ND EDITION 1899
- MAP 4: COPY OF RELEVANT AREA FROM ORDNANCE SURVEY 25" BERKS SH 13:12 3RD EDITION 1912
- FOUR PHOTOGRAPHS (A TO D) TAKEN RECENTLY OF SECTIONS OF BRIDLEWAY AT WESTERN END OF PACK LANE (CHILDREY, 17)
- 15 COMPLETED PUBLIC PATH EVIDENCE FORMS

Signed ...  ..

Date ~~25/12~~ 25/12/1977


* Delete as appropriate.

IN MY GENERAL COMMENTS AND OBSERVATIONS I REFER TO TWO AERIAL PHOTOGRAPHS SEEN AT OXFORDSHIRE STUDY CENTRE I DO NOT ATTACH COPIES WITH THIS FORM.

- 1) REFERENCE OCL 76/2579 AERIAL VIEWS SCALE 1:10600 SU 38 NWNE SU 39 SWSE. DATE OF PHOTO 14/6/1967
- 2) REFERENCE TS/4604 SU 38 NWNE SU 39 SWSE DATE OF PHOTO 31/5/1957

This copy has been produced specifically to supply an individual with added local authority information.
NO FURTHER COPIES MAY BE MADE

THIS IS NOT THE DEFINITIVE MAP

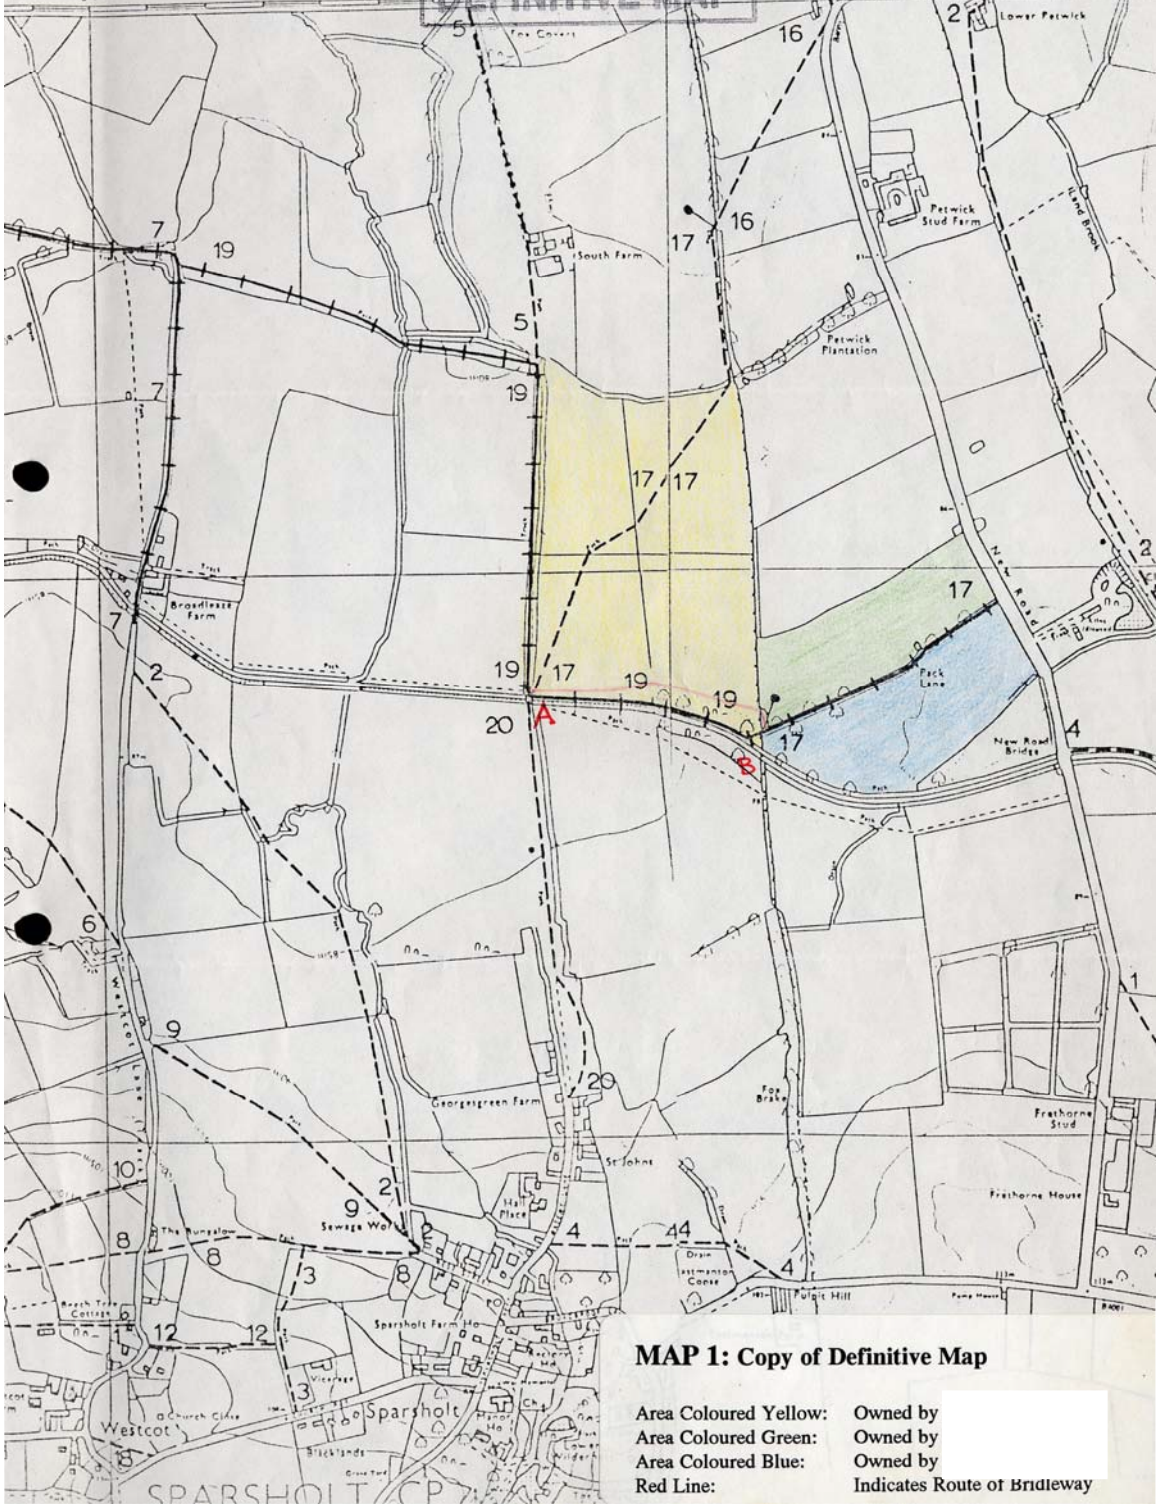

MAP 1: Copy of Definitive Map

- Area Coloured Yellow: Owned by
- Area Coloured Green: Owned by
- Area Coloured Blue: Owned by
- Red Line: Indicates Route of Brideway