


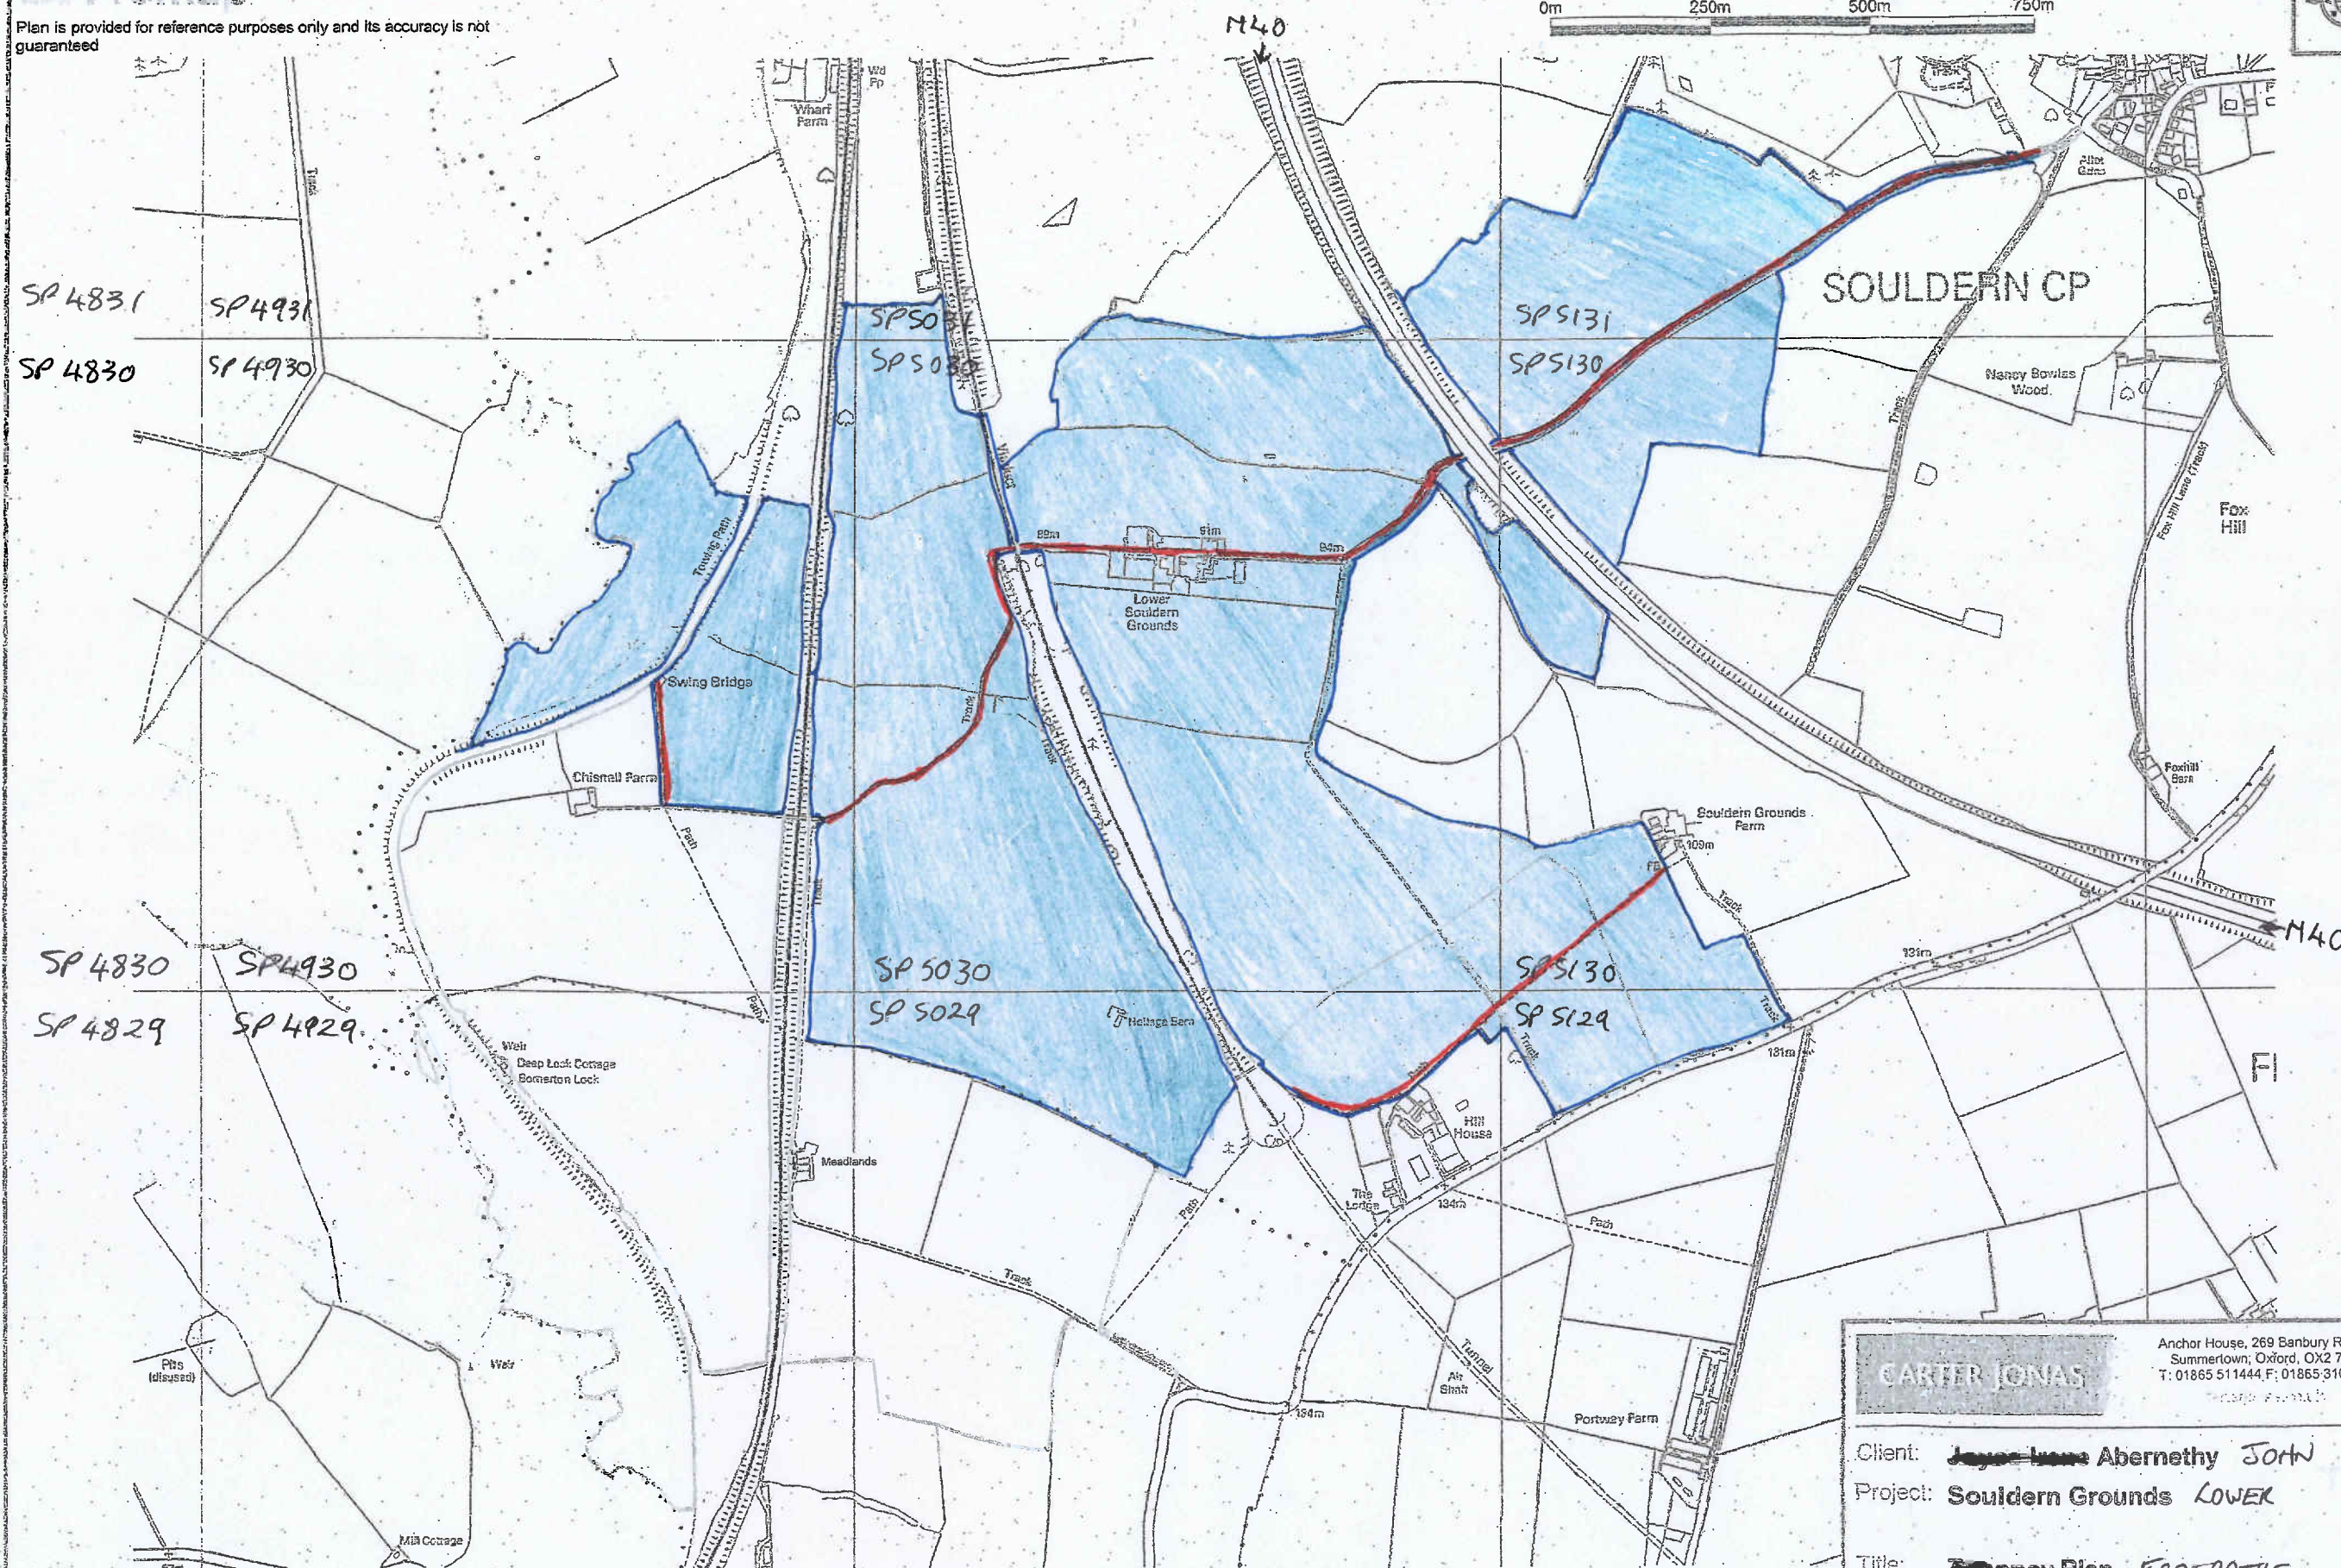

CARL JENAS

Anchor House, 269 Banbury Road,
Summertown, Oxford, OX2 7LL
T: 01865 511444 F: 01865 310653

Client: ~~James James~~ Abernethy JOHN

Project: **Souldern Grounds** *LOWER*

Title: ~~Emergency~~ Plan FOOTPATHS

Scale: 1:10000 @A3 Date: 09 August 2010

Drawn by: JP Dwg.no: GPC/JP/BN69403

4/8/2014