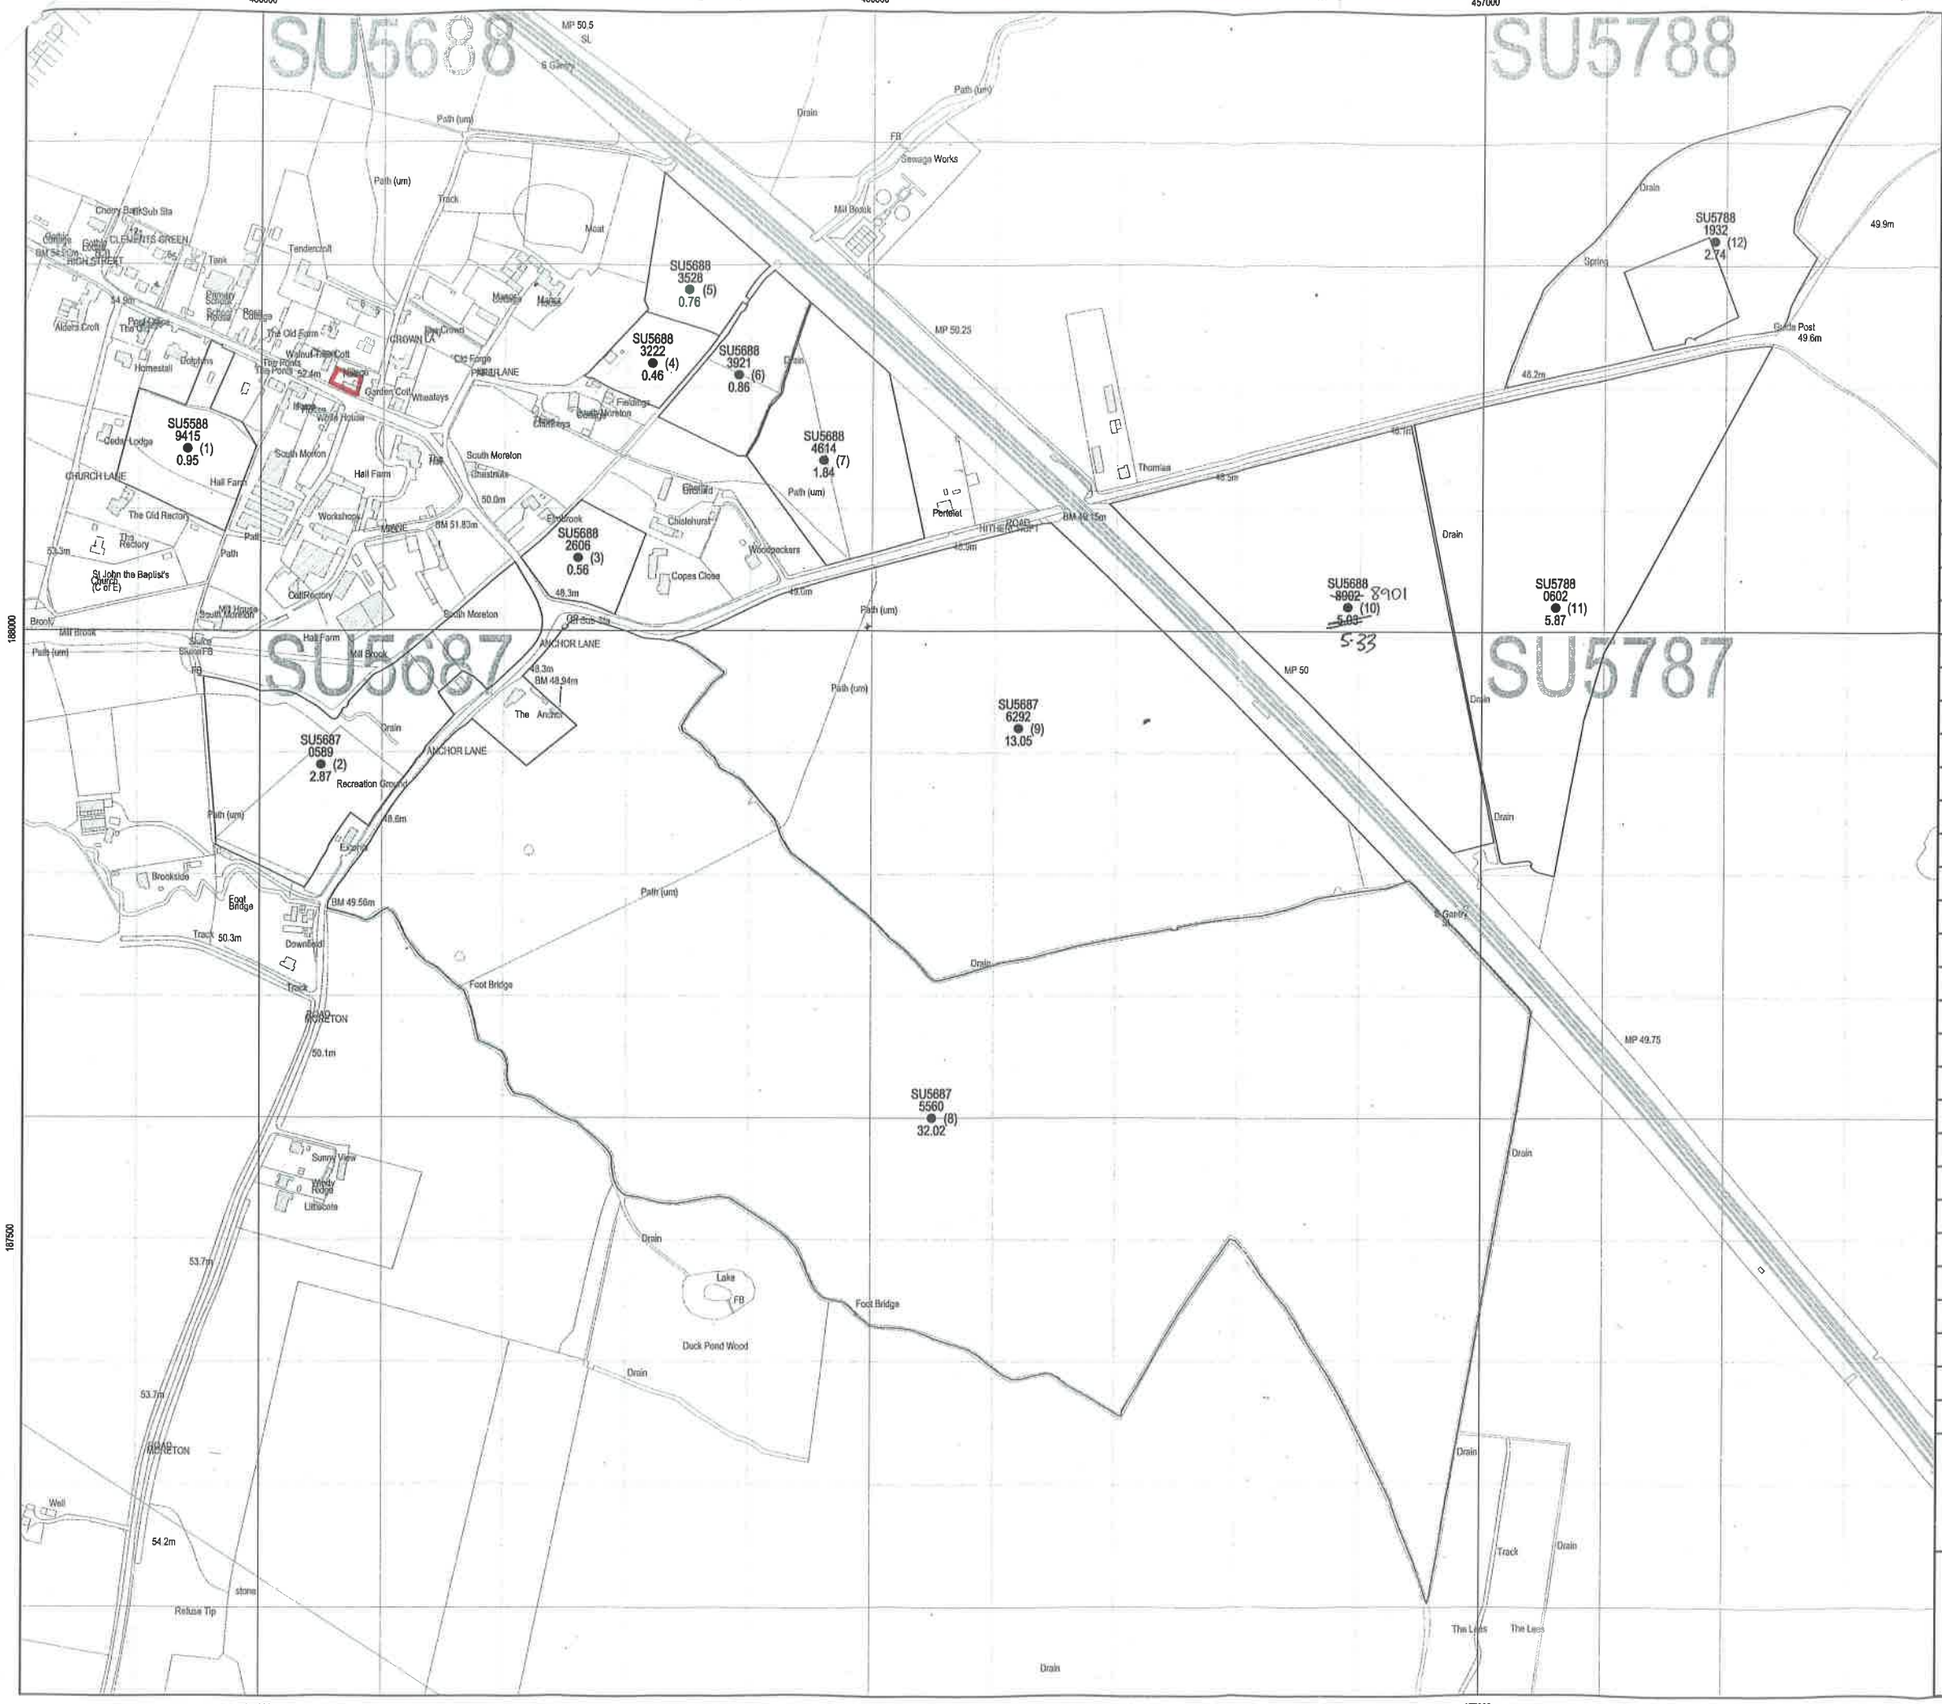


rpa
rural payments agency

Main Holding Number

**33/440/0031**

## Sheet Holding Number : 33/440/0031

### Rural Land Register

| Plot ID | Map Sheet<br>OS Map Sheet | Field Nos.<br>NG Field | Original Field Size (ha) | New Digital Field Size (ha) | Incorrect Boundary |
|---|---|---|---|---|---|
| 1 | SU5588 | 9415 | 0.95 | 0.95 | |
| 2 | SU5687 | 0589 | 2.87 | 2.87 | |
| 3 | SU5688 | 2606 | 0.56 | 0.56 | |
| 4 | SU5688 | 3222 | 0.46 | 0.46 | |
| 5 | SU5688 | 3528 | 0.76 | 0.76 | |
| 6 | SU5688 | 3921 | 0.86 | 0.86 | |
| 7 | SU5688 | 4614 | 1.84 | 1.84 | |
| 8 | SU5687 | 5560 | 32.02 | 32.02 | |
| 9 | SU5687 | 6292 | 13.05 | 13.05 | |
| ~~10~~ | ~~SU5688~~ | ~~8902~~ | ~~5.03~~ | ~~5.03~~ | |
| 11 | SU5788 | 0602 | 5.87 | 5.87 | |
| 12 | SU5788 | 1932 | 2.74 | 2.74 | |
| 10 | SU5688 | 8901 | 5.33 | 5.33 | |

Print Name : .....

Signed : ..... Date : .....

N

**Scale 1:5000**

0m 50m 100m 150m 200m 250m

Date printed : 10/03/2005

Version : Final

This map is reproduced from Ordnance Survey material with the permission of Ordnance Survey on behalf of the Controller of Her Majesty's Stationery Office. © Crown copyright. Unauthorised reproduction infringes Crown copyright and may lead to prosecution or civil proceedings. DEFRA licence No 100018880 2005

Printed by : CIRL