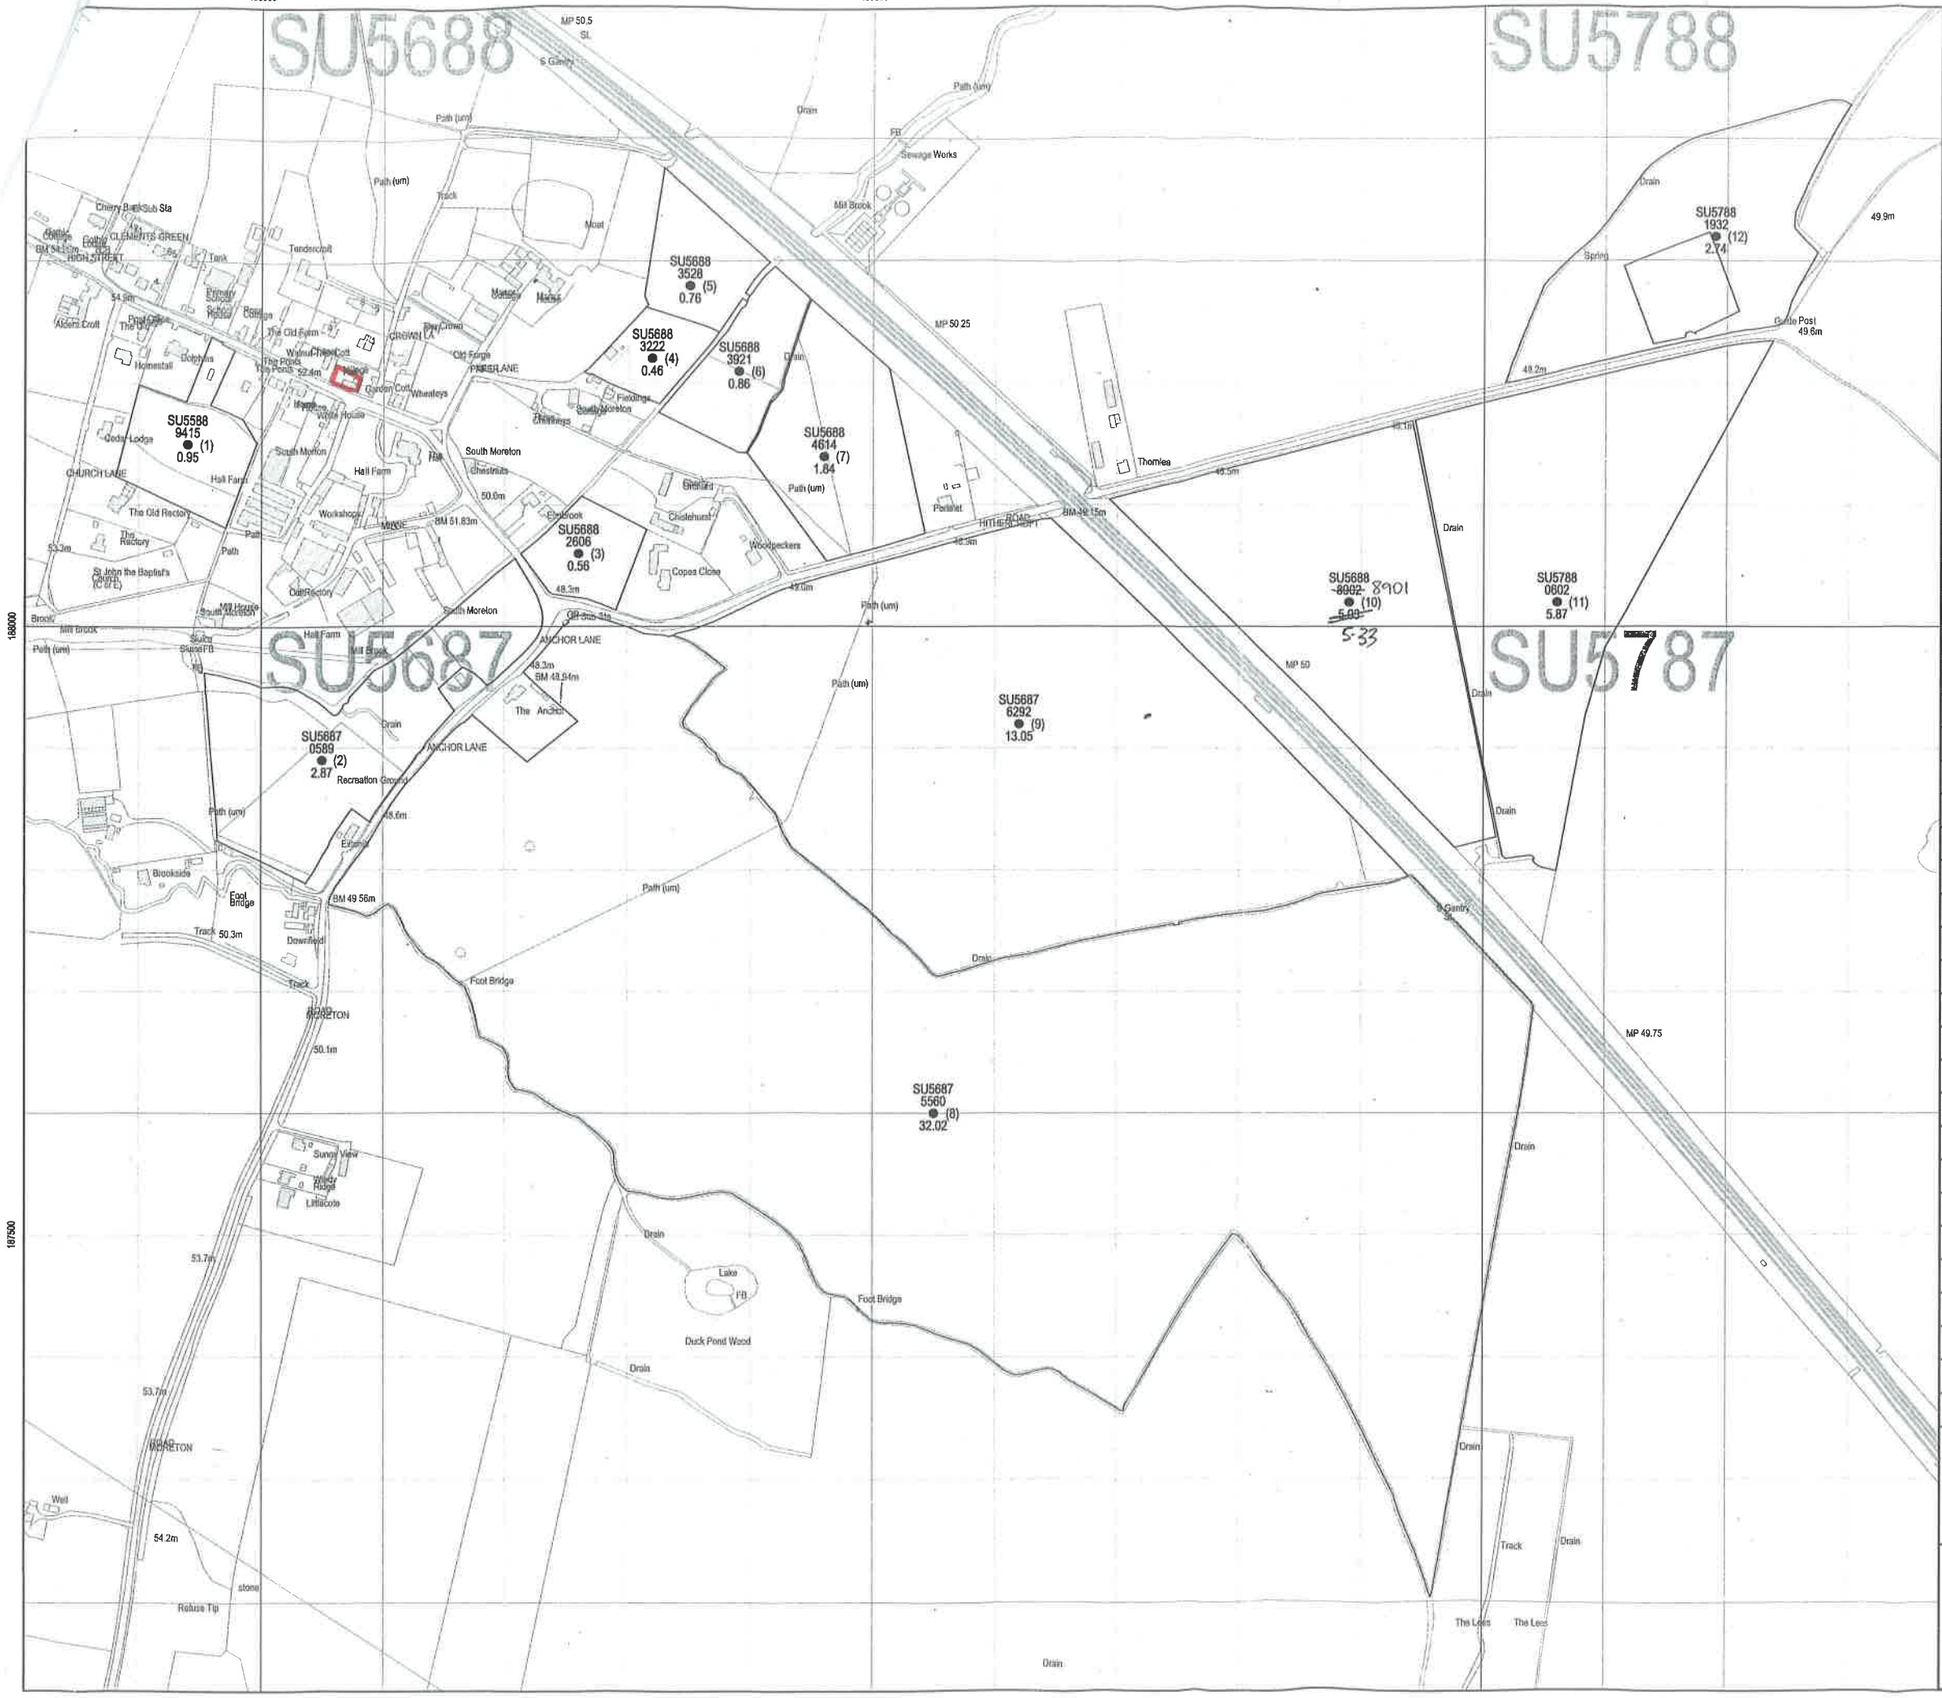

rpa
rural payments agency

Main Holding Number

33/440/0031

Sheet Holding Number : 33/440/0031

Rural Land Register

Plot ID	Map Sheet OS Map Sheet	Field Nos. NG Field	Original Field Size (ha)	New Digital Field Size (ha)	Incorrect Boundary
1	SU5588	9415	0.95	0.95	
2	SU5687	0589	2.87	2.87	
3	SU5688	2606	0.56	0.56	
4	SU5688	3222	0.46	0.46	
5	SU5688	3528	0.76	0.76	
6	SU5688	3921	0.86	0.86	
7	SU5688	4614	1.84	1.84	
8	SU5687	5560	32.02	32.02	
9	SU5687	6292	13.05	13.05	
~~10~~	~~SU5688~~	~~8902~~	~~5.03~~	~~5.03~~	
11	SU5788	0602	5.87	5.87	
12	SU5788	1932	2.74	2.74	
10	SU5688	8901	5.33	5.33	

Print Name : .....

Signed : ..... Date : .....

N

Scale 1:5000

0m 50m 100m 150m 200m 250m

Date printed : 10/03/2005

Version : Final

This map is reproduced from Ordnance Survey material with the permission of Ordnance Survey on behalf of the Controller of Her Majesty's Stationery Office. © Crown copyright. Unauthorised reproduction infringes Crown copyright and may lead to prosecution or civil proceedings. DEFRA licence No 100018880 2005

Printed by : CIRL